



PIANO UFFICI E MENSA

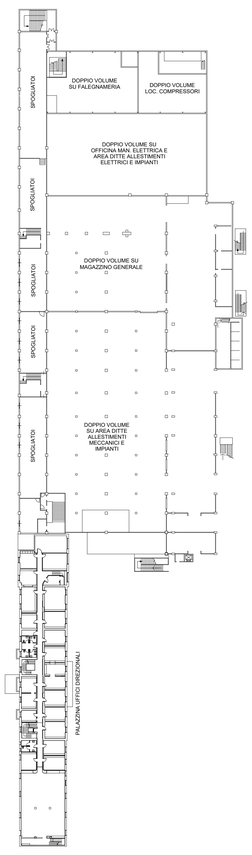

PIANO SPOGLIATOI

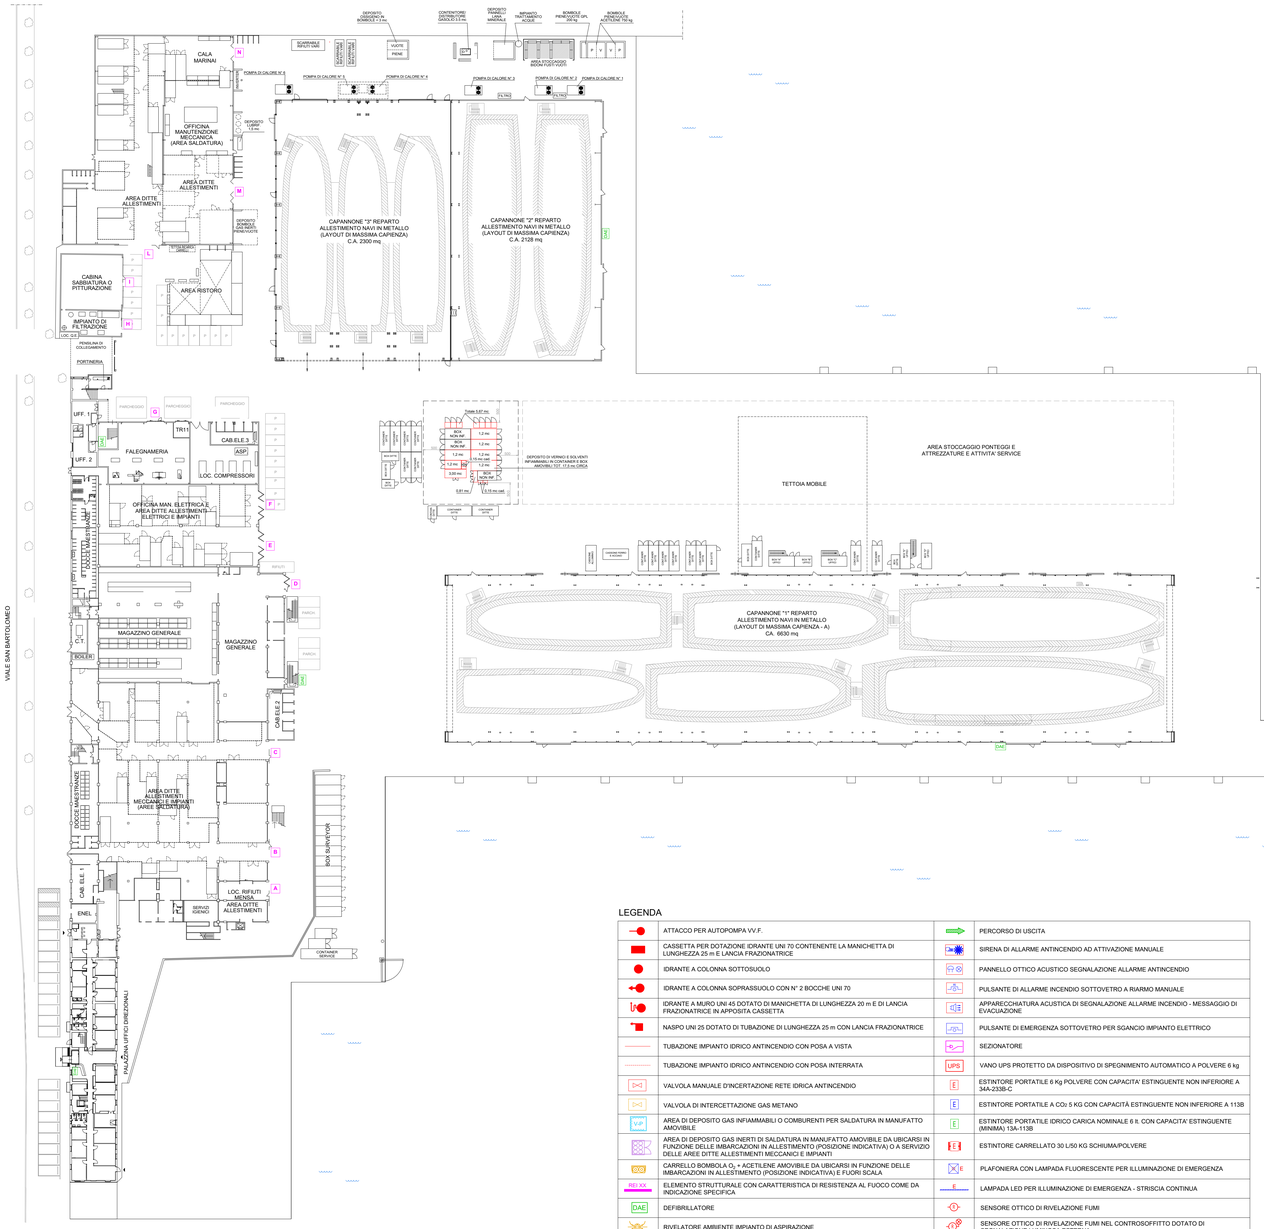

PIANO TERRA

LEGENDA

	ATTACCO PER AUTOPOMPA VV.F.		PERCORSO DI USCITA
	CASSETTA PER DOTAZIONE IDRANTE UNI 70 CONTENENTE LA MANICHETTA DI LUNGHEZZA 25 m E LANCIA FRAZIONATRICE		SIRENA DI ALLARME ANTINCENDIO AD ATTIVAZIONE MANUALE
	IDRANTE A COLONNA SOTTOSUOLO		PANNELLO OTTICO ACUSTICO SEGNALAZIONE ALLARME ANTINCENDIO
	IDRANTE A COLONNA SOPRASSUOLO CON N° 2 BOCCHE UNI 70		PULSANTE DI ALLARME INCENDIO SOTTOVETRO A RIARMO MANUALE
	IDRANTE A MURO UNI 45 DOTATO DI MANICHETTA DI LUNGHEZZA 20 m E DI LANCIA FRAZIONATRICE IN APPOSITA CASSETTA		APPARECCHIATURA ACUSTICA DI SEGNALAZIONE ALLARME INCENDIO - MESSAGGIO DI EVACUAZIONE
	NASPO UNI 25 DOTATO DI TUBAZIONE DI LUNGHEZZA 25 m CON LANCIA FRAZIONATRICE		PULSANTE DI EMERGENZA SOTTOVETRO PER SGANCIO IMPIANTO ELETTRICO
	TUBAZIONE IMPIANTO IDRICO ANTINCENDIO CON POSA A VISTA		SEZIONATORE
	TUBAZIONE IMPIANTO IDRICO ANTINCENDIO CON POSA INTERRATA	UPS	VANO UPS PROTETTO DA DISPOSITIVO DI SPEGNIMENTO AUTOMATICO A POLVERE 6 kg
	VALVOLA MANUALE D'INCERTAZIONE RETE IDRICA ANTINCENDIO		ESTINTORE PORTATILE 6 Kg POLVERE CON CAPACITA' ESTINGUENTE NON INFERIORE A 34A-233B-C
	VALVOLA DI INTERCETTAZIONE GAS METANO		ESTINTORE PORTATILE A CO2 5 KG CON CAPACITÀ ESTINGUENTE NON INFERIORE A 113B
V.P.	AREA DI DEPOSITO GAS INFIAMMABILI O COMBURENTI PER SALDATURA IN MANUFATTO AMOVIBILE		ESTINTORE PORTATILE IDRICO CARICA NOMINALE 6 lt. CON CAPACITA' ESTINGUENTE (MINIMA) 13A-113B
	AREA DI DEPOSITO GAS INERTI DI SALDATURA IN MANUFATTO AMOVIBILE DA UBICARSI IN FUNZIONE DELLE IMBARCAZIONI IN ALLESTIMENTO (POSIZIONE INDICATIVA) O A SERVIZIO DELLE AREE DITTE ALLESTIMENTI MECCANICI E IMPIANTI		ESTINTORE CARRELLATO 30 LI50 KG SCHIUMA/POLVERE
	CARRELLO BOMBOLA O_2 + ACETILENE AMOVIBILE DA UBICARSI IN FUNZIONE DELLE IMBARCAZIONI IN ALLESTIMENTO (POSIZIONE INDICATIVA) E FUORI SCALA		PLAFONIERA CON LAMPADA FLUORESCENTE PER ILLUMINAZIONE DI EMERGENZA
REI XX	ELEMENTO STRUTTURALE CON CARATTERISTICA DI RESISTENZA AL FUOCO COME DA INDICAZIONE SPECIFICA		LAMPADA LED PER ILLUMINAZIONE DI EMERGENZA - STRISCIA CONTINUA
DAE	DEFIBRILLATORE		SENSORE OTTICO DI RIVELAZIONE FUMI
	RIVELATORE AMBIENTE IMPIANTO DI ASPIRAZIONE		SENSORE OTTICO DI RIVELAZIONE FUMI NEL CONTROSOFFITTO DOTATO DI SEGNALAZIONE LUMINOSA ESTERNA
	CENTRALINA DI CONTROLLO RIVELATORI IMPIANTO DI ASPIRAZIONE		QUADRO ELETTRICO

NORD

SANLORENZO

LA SPEZIA

COMMITTENTE
SANLORENZO S.p.A.
Via Armezzone, 3
19031 Ameglia (SP)

ENTI INTERESSATI
Comando Provinciale VV.F.
di La Spezia

UBICAZIONE
Viale San Bartolomeo
19126 La Spezia (SP)

PRATICA
SEGNALAZIONE CERTIFICATA DI INIZIO ATTIVITA'
Art. 4 comma 1 D.P.R. n. 151/2011
Art. 4 comma 1 D.M. 07/08/2012

CANTIERE NAVALE CON OLTRE 25 ADDETTI

ATTIVITA' PRINCIPALE N. 52.2.C
di cui all'allegato I del D.P.R. 151/2011

Pratica VV.F. n. 7473

DESCRIZIONE
- LAYOUT GENERALE
- POSIZIONI DEI DEFIBRILLATORI

TAVOLA VVF01

PLANIMETRIA AS-BUILT

SCALA 1:500

DATA: Febbraio 2025


FILE: slzSP24_015.dwg

REV.	DESCRIZIONE	DATA
00	PRIMA EMISSIONE	01/2025
01	MODIFICA LUCI DI SICUREZZA	02/2025

Il Tecnico

ST ENGINEERING
progettazione e consulenza
Per. Ind. Stefano Andreini
Per. Ind. Federico Guggi
Per. Ind. Gianluca Macelloni
Collaboratori:
Per. Ind. Mauro Del Freo
Geom. Micaela Fava
Ing. Sara Pucci
ST ENGINEERING S.r.l.
Via delle Cornacchie n° 960/F
web www.steng.it
e-mail info@steng.it
PEC pec@pec.steng.it
P.IVA 01233650462
Tel./Fax +39 0583 490690
partner
TEAMPROJECT PROGETTAZIONE INTEGRATA

Tutti i diritti di riproduzione anche parziale e con qualsiasi mezzo sono riservati, (art. 2575 ss. del cod. civ.)
Senza nostra autorizzazione scritta gli elementi forniti da ritenersi indicativi e pertanto non hanno valenza architettonica.

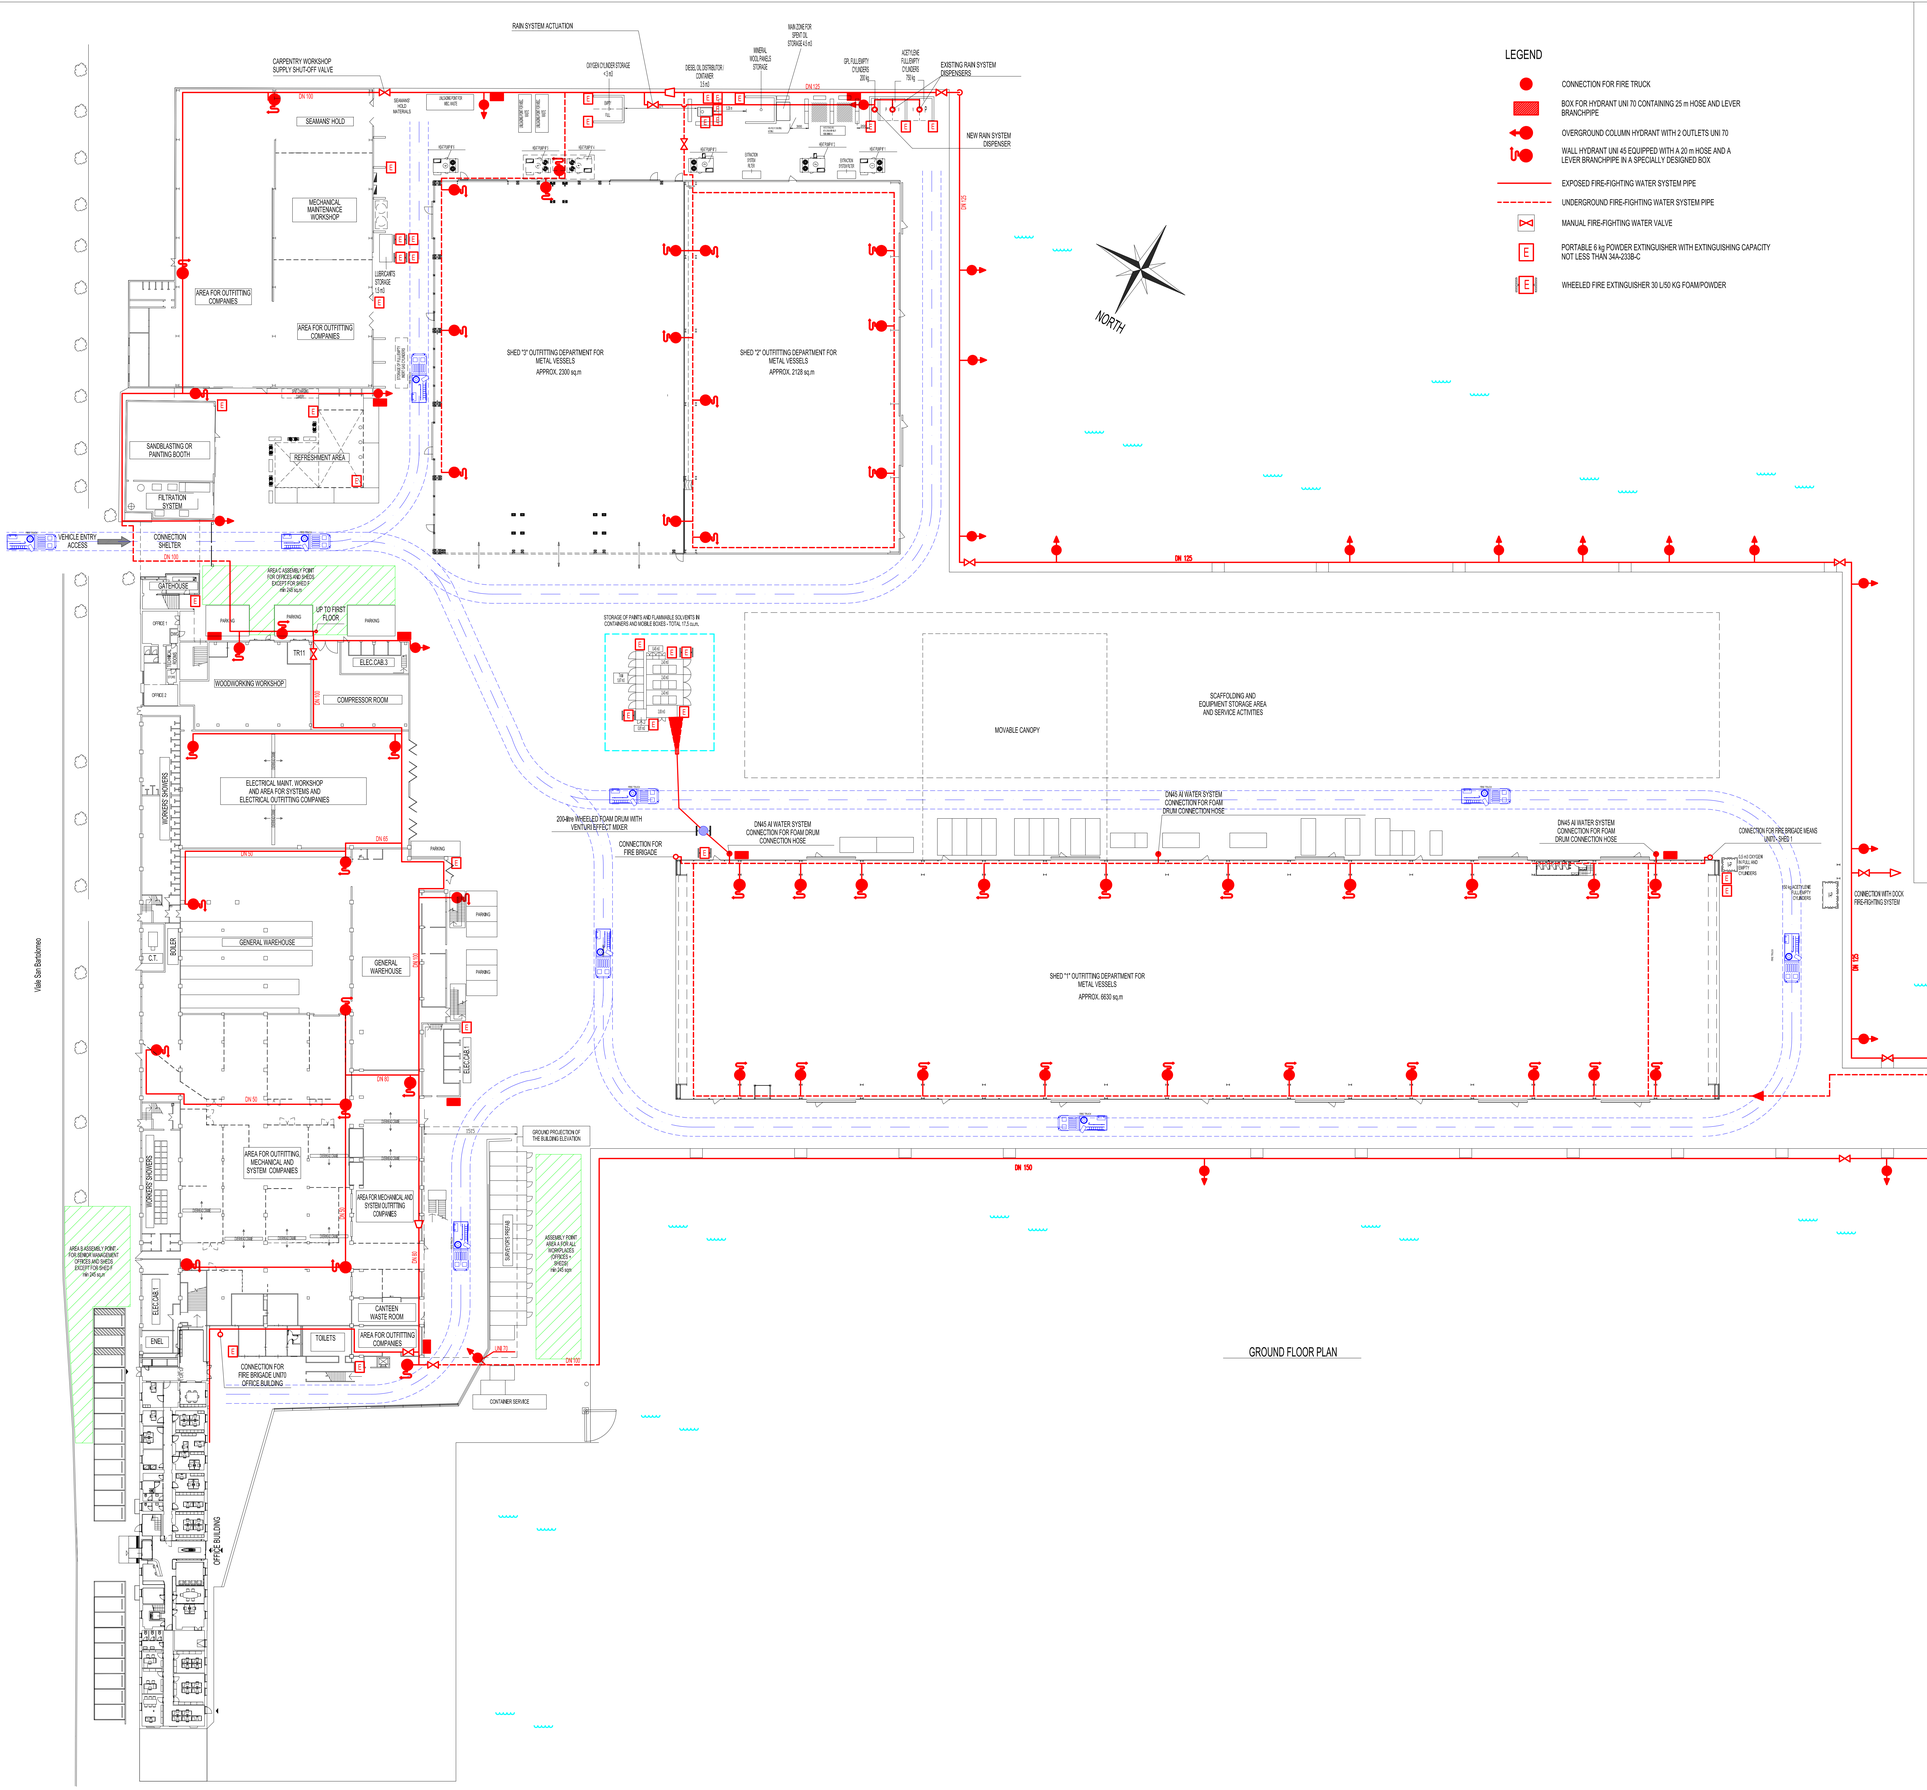

GROUND FLOOR PLAN

LEGEND

- CONNECTION FOR FIRE TRUCK
- BOX FOR HYDRANT UNI 70 CONTAINING 25 m HOSE AND LEVER BRANCHPIPE
- OVERGROUND COLUMN HYDRANT WITH 2 OUTLETS UNI 70
- WALL HYDRANT UNI 45 EQUIPPED WITH A 20 m HOSE AND A LEVER BRANCHPIPE IN A SPECIALLY DESIGNED BOX
- EXPOSED FIRE-FIGHTING WATER SYSTEM PIPE
- UNDERGROUND FIRE-FIGHTING WATER SYSTEM PIPE
- MANUAL FIRE-FIGHTING WATER VALVE
- PORTABLE 6 kg POWDER EXTINGUISHER WITH EXTINGUISHING CAPACITY NOT LESS THAN 34A-233B-C
- WHEELED FIRE EXTINGUISHER 30 L/50 KG FOAM/POWDER

SANLORENZO

La Spezia

CUSTOMER

SANLORENZO S.p.A.
Viale San Bartolomeo
19126 La Spezia (SP)

ORGANISATIONS INVOLVED

La Spezia Provincial Fire Brigade Command

FILE

MODIFICATION OF EXISTING ACTIVITY OF SHIPYARD WITH MORE THAN 25 EMPLOYEES

ACTIVITY NO. 52.2.C OF ANNEX I OF D.P.R. N°151/2011

PROJECT EVALUATION
(Art. 3 of D.P.R. n.151 of 01/08/2011 - Art. 3 D.M. 07/08/2012)

IN ACCORDANCE WITH FIRE PREVENTION CRITERIA AS PER MINISTERIAL DECREE 03/08/2015

PRODUCTION SITE
- ACCESSIBILITY OF EMERGENCY VEHICLES
- ASSEMBLY POINT - "SAFE PLACE"
- FIRE EXTINGUISHING EQUIPMENT

FIRE BRIGADE DOSSIER. N° 7473

TABLE	SCALE
AI02	1/500

DATE: JUNE 2023

DOSSIER: slzSP23_002.d

REV.	DESCRIPTION	Date
00	FIRST ISSUE	05/2023
01	SECOND ISSUE	06/2023

The Technical

ST ENGINEERING design and consultancy

For Stefano Andreini
For Federico Guiggi
For Gianluca Macelloni

ST ENGINEERING S.r.l.
Via delle Cornacchie, 960/F
55100 Lucca (LU)

web www.steng.it
e-mail info@steng.it
PEC pec@pec.steng.it

VAT Number/Tax Code 01233650462
Telephone/Fax +39 0583 490690

partner TEAMPROJECT INTEGRATED DESIGN

All reproduction rights, even partial and by any means, are reserved (Art. 2575 of the Italian Civil Code)

Except where indicated, the diagrams are to be considered by way of example only and therefore have no architectural value.

SANLORENZO S.p.A.


Ragione sociale:
SANLORENZO S.p.A.

Sede legale:
Via Armezzone, 3
19031 Ameglia (SP)

Unità produtt iva:
Unità produttiva della Spezia - B.U. SUPERYACHT
Viale San Bartolomeo, 362
19126 La Spezia

DISPOSIZIONE AREE FUMO

Agg. del 14.04.2022

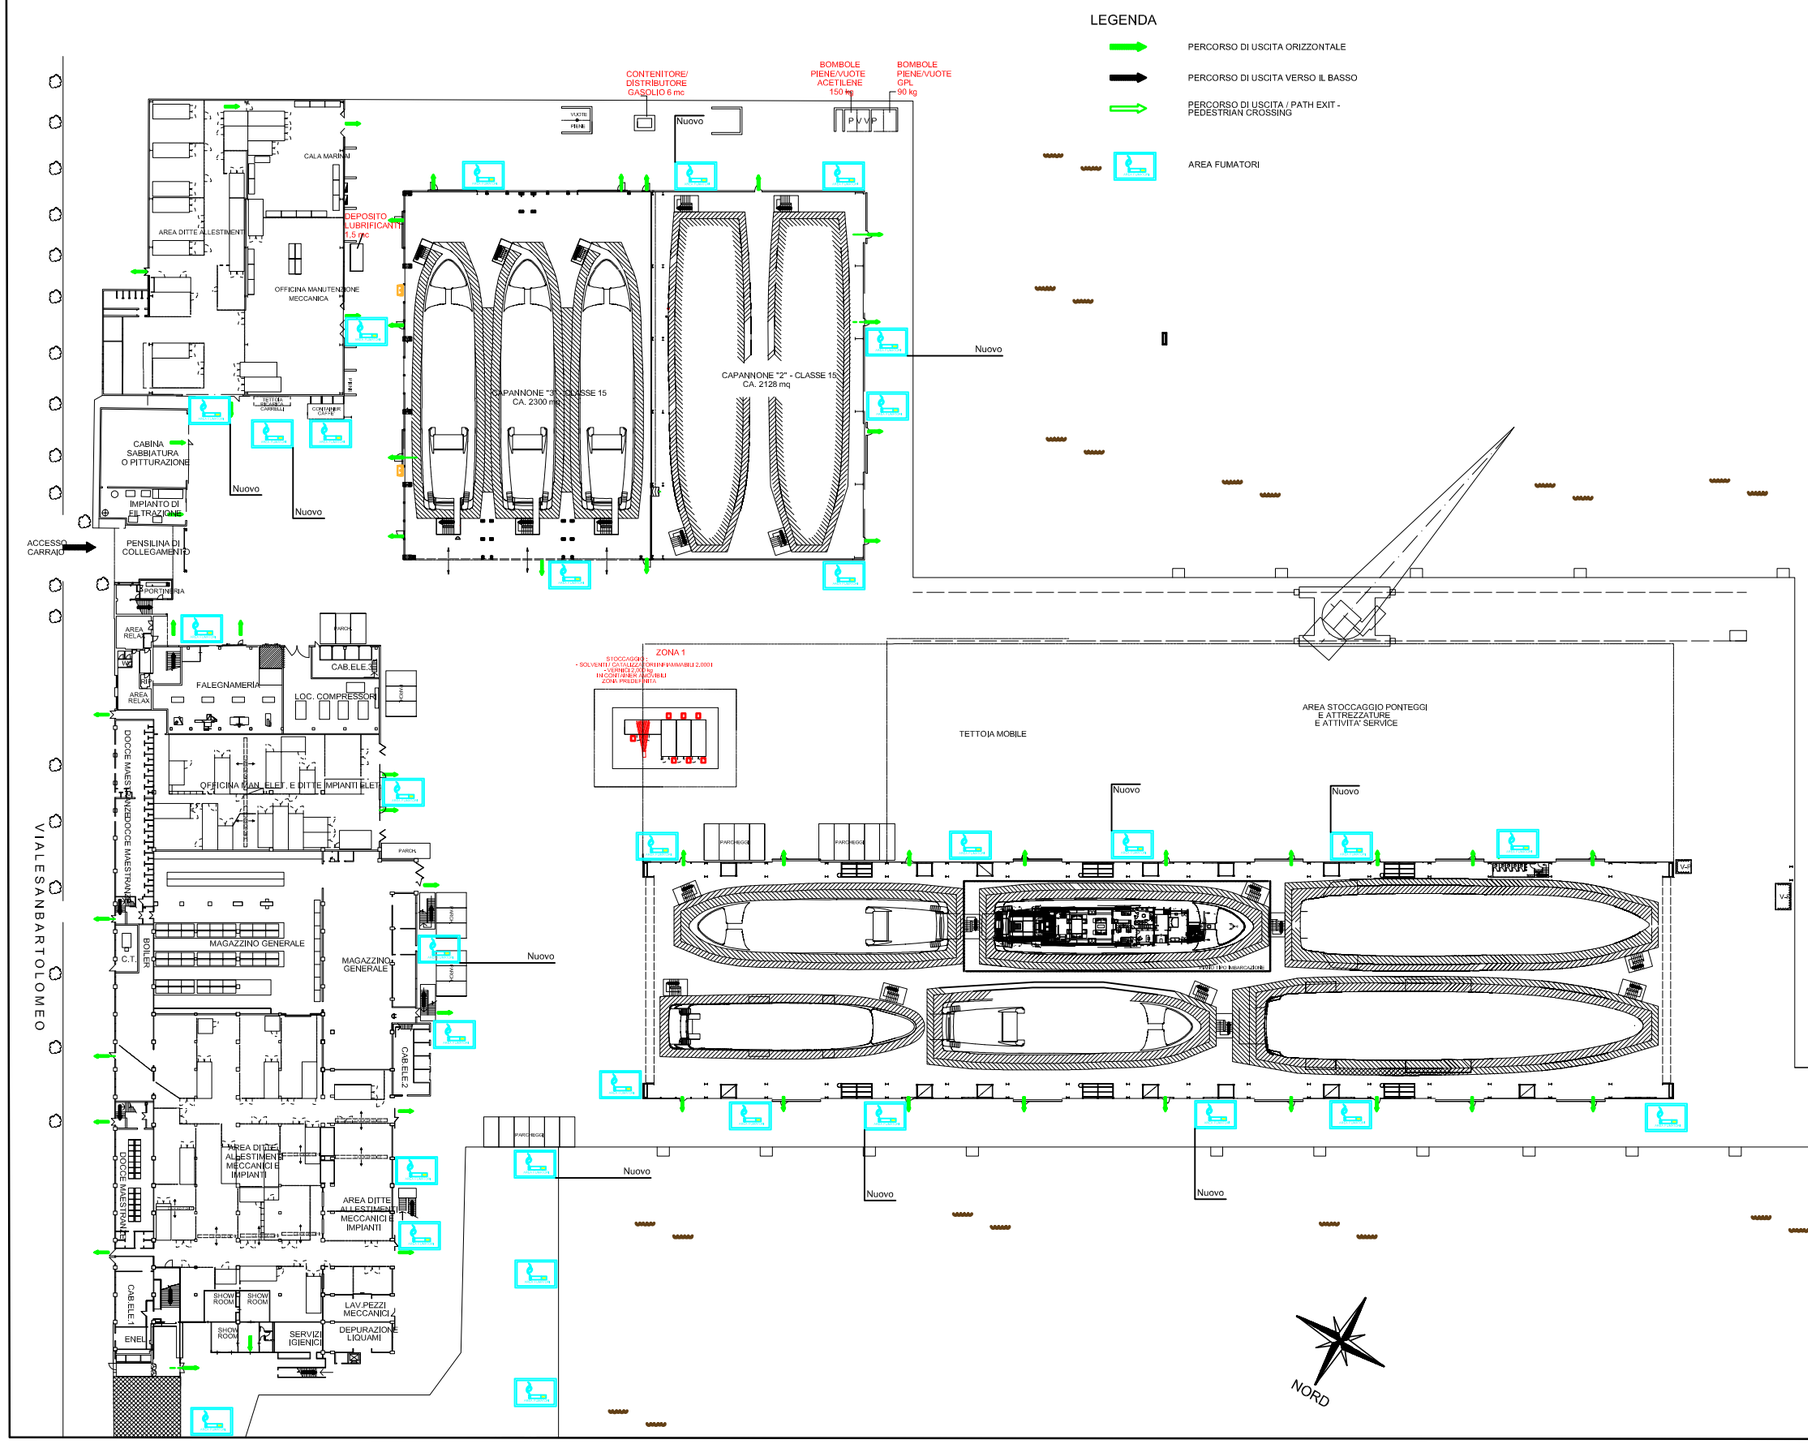

EMERGENCY EVACUATION PROCEDURES

<u>Emergencies are signaled by audible alarms</u>

WHOSOEVER

Must , in the case of an emergency or if they personally witness the start of a fire:

-Immediately inform one of the Emergency Managers shown below

-Not approach the emergency location or where the fire has started for any reason, unless the Emergency Managers indicate otherwise;

-In an orderly fashion head towards the muster point situated in the center of the yard area nearby by marked area (yellow square);

-Not obstruct emergency interventions;
-If situated near an exit, prompt exit;

-If situated near an entrance, not enter and avoid blocking the exit via the same entrance;

-Not stay downwind;

-Not use the telephone or radio;

-Not leave the muster point before having informed one of the Emergency Managers that they will be leaving the workplace.

In case of emergency , <u>PERSONNEL</u> must:

-Assist with evacuation procedures;

-Make sure that everyone follows the escape routes;

-Make sure that all those involved in the emergency move towards the muster point;

-Inform the Dire Dept;

-Assist the Fire Dept. upon their arrival.

IN CASE OF EMERGENCY – FIRE CONTACT:

FIRE DEPT/POLICE/CARABINIERI/EMERGENCY MEDICAL CARE : phone n° 112

EMERGENCY SHIPYARD MANAGERS:

Damiano Ferdani: d.ferdani@sanlorenzoyacht.com

Filippo Agostinetti: f.agostinetti@sanlorenzoyacht.com

Nicòlo Grillone: n.grillone@sanlorenzoyacht.com